

SYSTEM ELEVATIONS

AS-BUILT PLAN

T.C. (SLAB)	194.49	194.49
INV. AT BLDG TO G.T.	190.81	190.81
INV. AT BLDG TO S.T.	190.72	190.72
GREASE TRAP IN	190.10	190.10
GREASE TRAP OUT	189.99	189.98
SEPTIC TANK IN G.T.	189.08	189.96
SEPTIC TANK IN BLD.	189.14	189.84
SEPTIC TANK OUT	188.82	189.78
PUMP CHAMBER IN	188.73	189.48
PUMP CHAMBER OUT	189.30	189.30
DIST. BOX IN	192.72	192.61
DIST. BOX OUT	192.57	192.30
BEG. L-1	192.11	192.10
BEG. L-2	192.09	192.10
BEG. L-3	192.08	192.10
END L-1	191.80	191.80
END L-2	191.82	191.80
END L-3	191.81	191.80

SYSTEM TIES



STATION	A	B
GREASE TRAP M.H. IN	44.7	26.8
GREASE TRAP M.H. OUT	47.3	30.9
S.T. MANHOLE IN	41.7	34.2
S.T. MANHOLE OUT	36.1	39.0
P.C. MANHOLE IN	32.5	45.4
P.C. MANHOLE OUT	36.8	48.5
DIST. BOX	35.15	61.30
BEG. L1	42.00	69.15
END L1	70.05	112.60
BEG. L2	30.30	62.50
END L2	63.80	108.80
BEG. L3	19.00	58.10
END L3	59.40	106.40
VENT	72.90	115.65

NOTE:

1. PUMP CHAMBER PROVIDES APPROXIMATELY 550 GALLONS OR 1.1 DAYS OF EMERGENCY STORAGE CAPACITY.

POND (PUBLIC WAY) STREET - RTE. 126

246.08

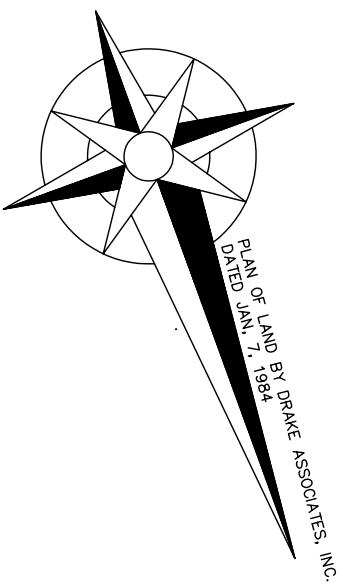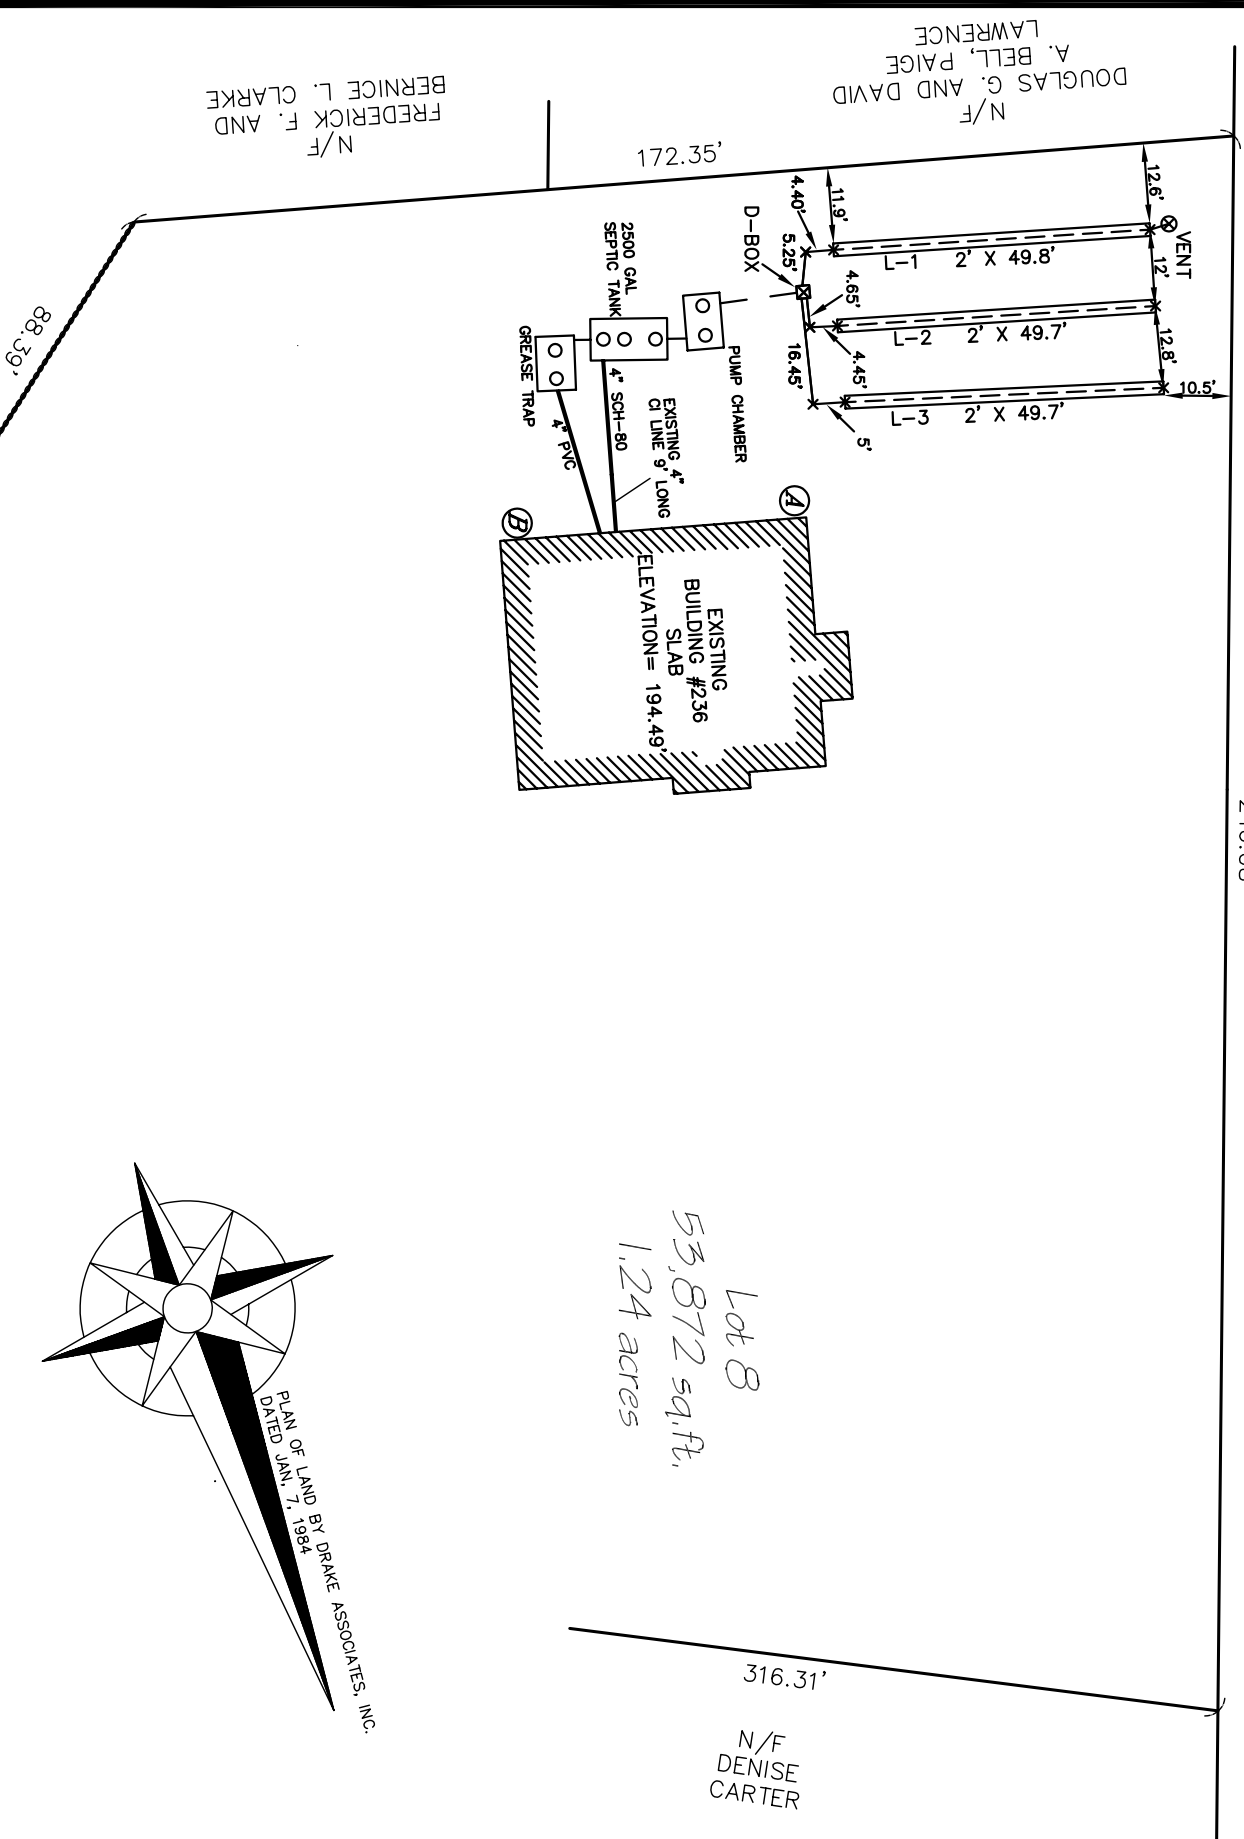


AS-BUILT SEPTIC
IN
ASHLAND, MASS.

SCALE: 1" = 30' DATE: JANUARY 24, 2002

LOCATION: #236 POND STREET

PREPARED FOR: HONEY DEW DONUTS

ENGINEERS & SURVEYORS:

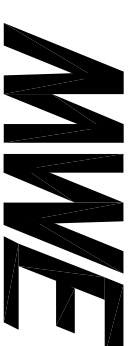

METROWEST ENGINEERING, INC.
75 FRANKLIN STREET
FRAMINGHAM, MA 01702
ROBERT A. GEMMA, PLS 37046

I CERTIFY THAT THE SEPTIC SYSTEM, AS-BUILT, CONFORMS TO TITLE 5, AND THE REQUIREMENTS OF THE ASHLAND BOARD OF HEALTH.

I CERTIFY THAT THE LOT SHOWN AND SEPTIC SYSTEM THEREON IS NOT WITHIN THE FEDERAL FLOOD HAZARD.

NOTES

THIS PLAN IS PREPARED FROM LINES OF OCCUPATION. THE TIES TO THE LOT LINES ARE NOT TO BE USED IN THE SETTING OF FENCES, HEDGES, ETC.

AB012202